


IZVEDENO STANJE

TLOCRT PODRUMA

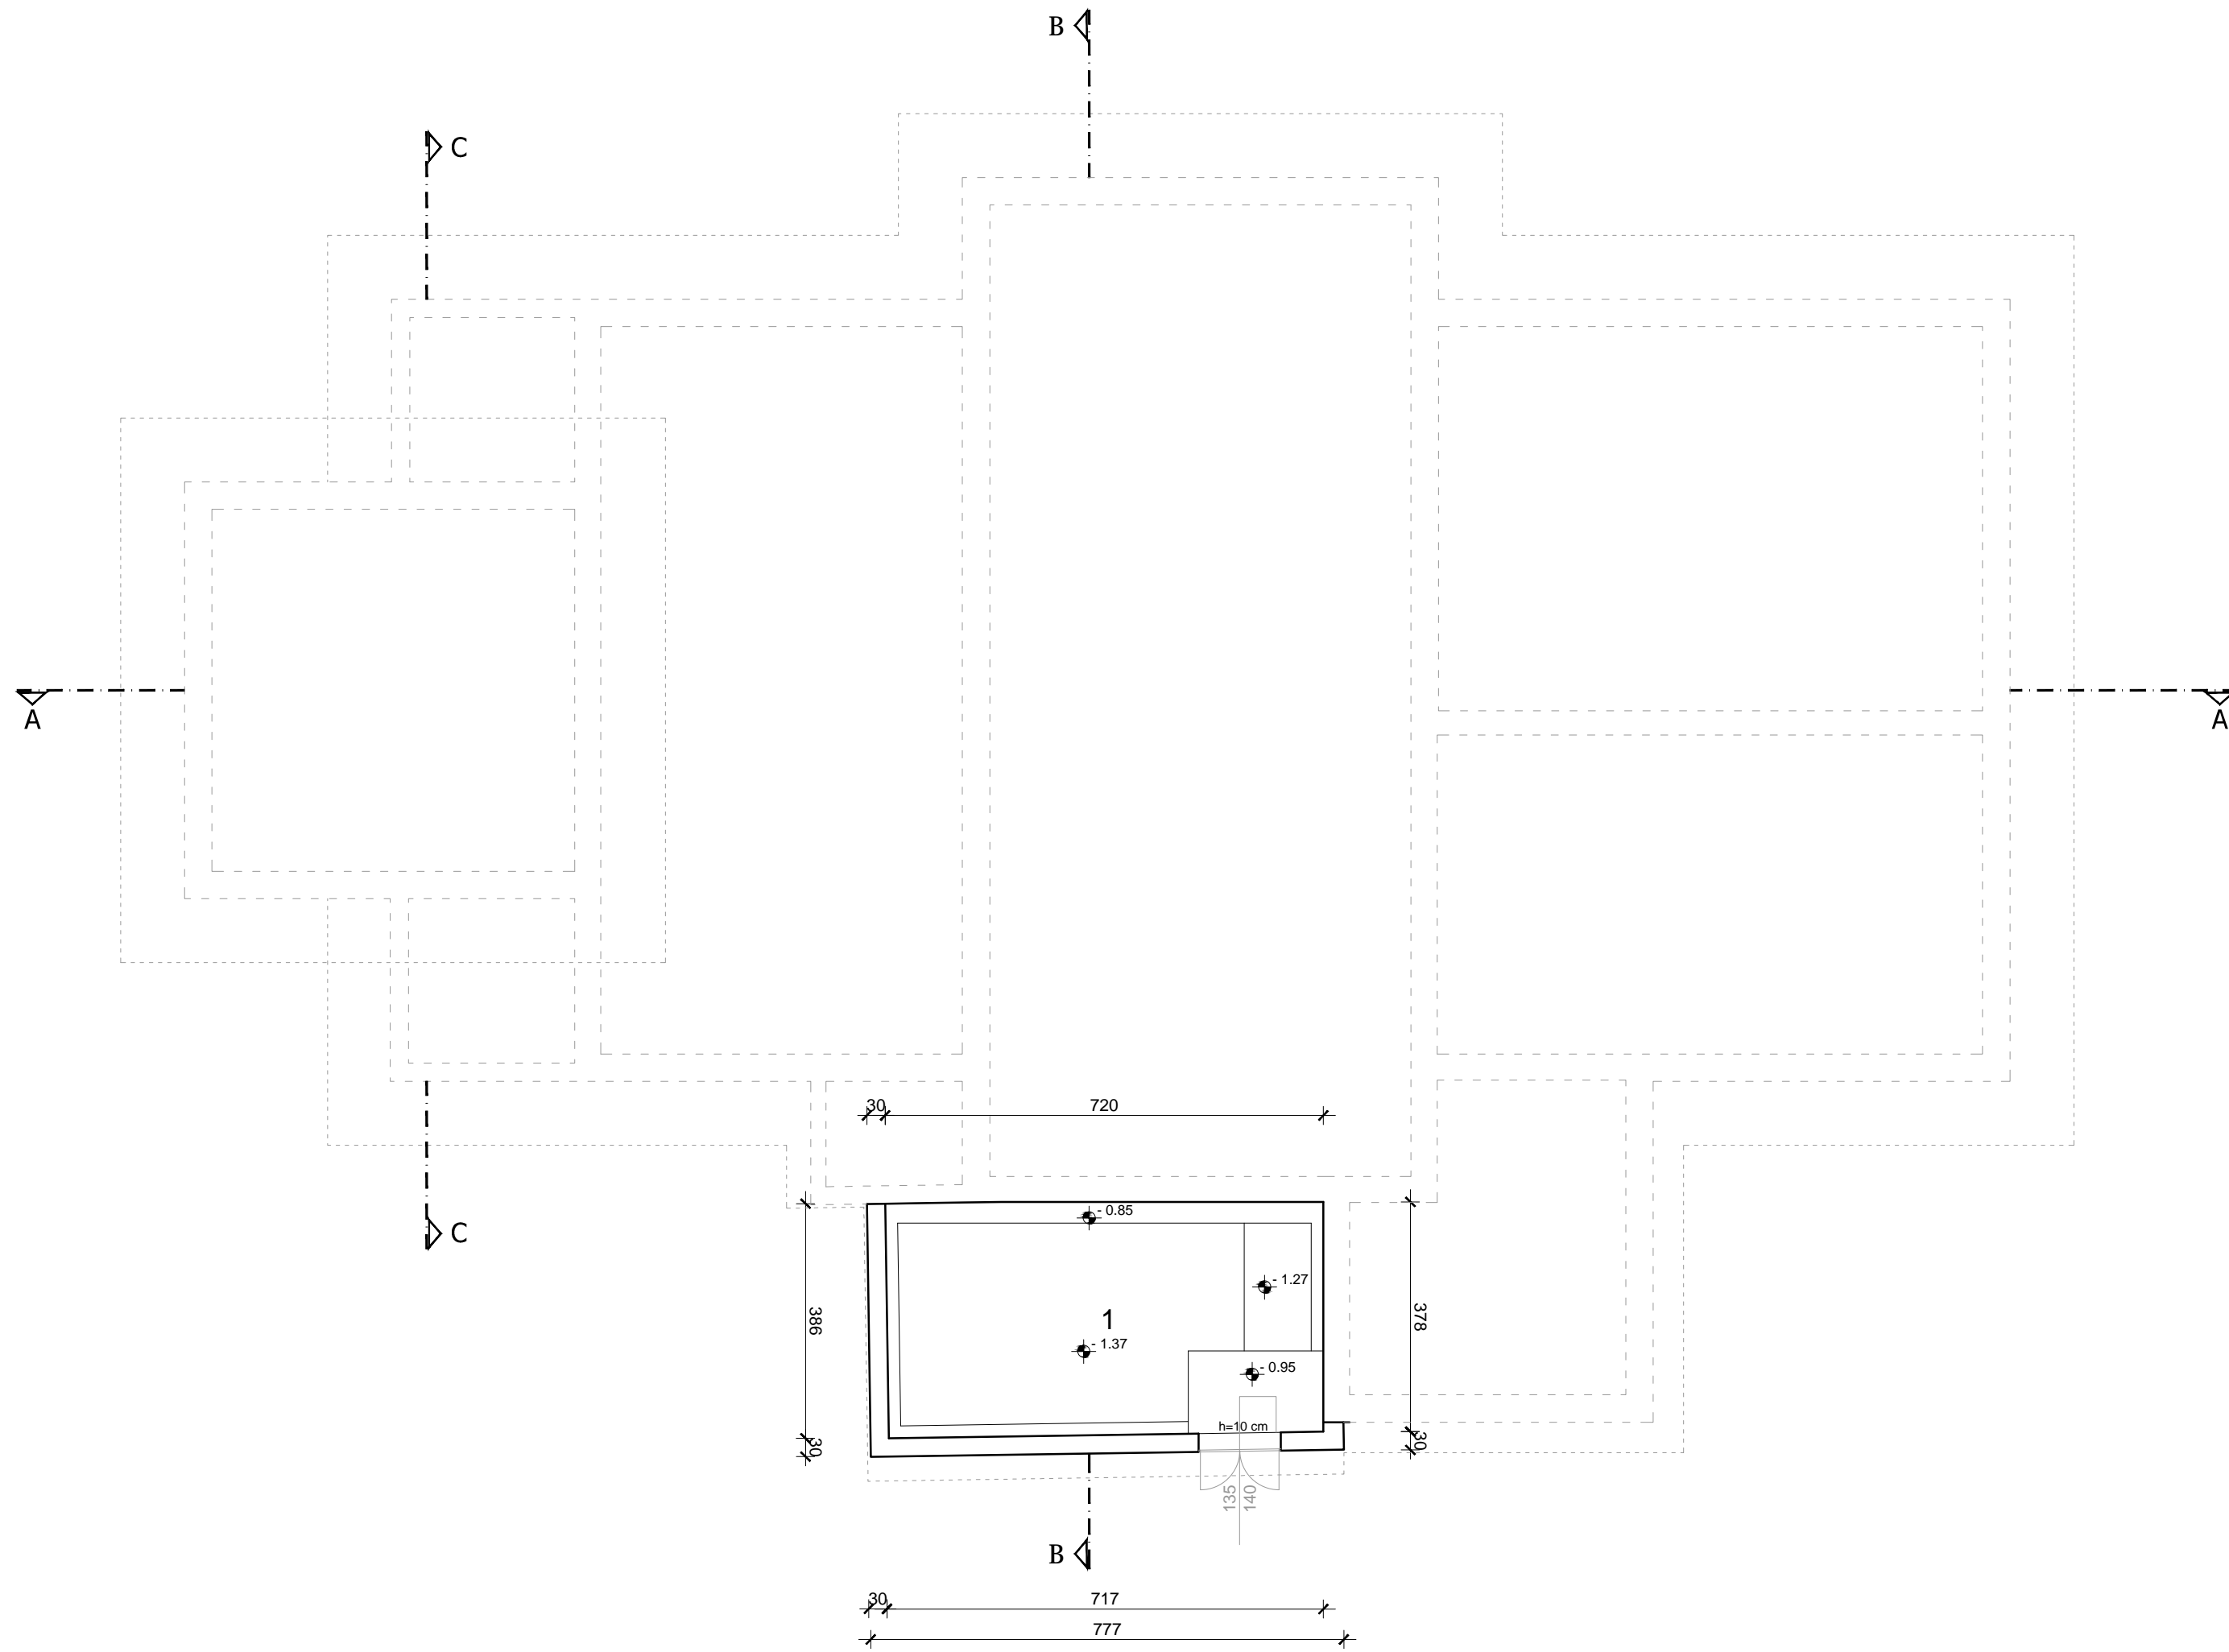

1 - PROSTORIJA 1	beton	P = 27,44 m <sup>2</sup>
PODRUM NETO UKUPNO		P = 27,44 m <sup>2</sup>



		LIST: 1