


IZVEDENO STANJE

PRESJEK B-B

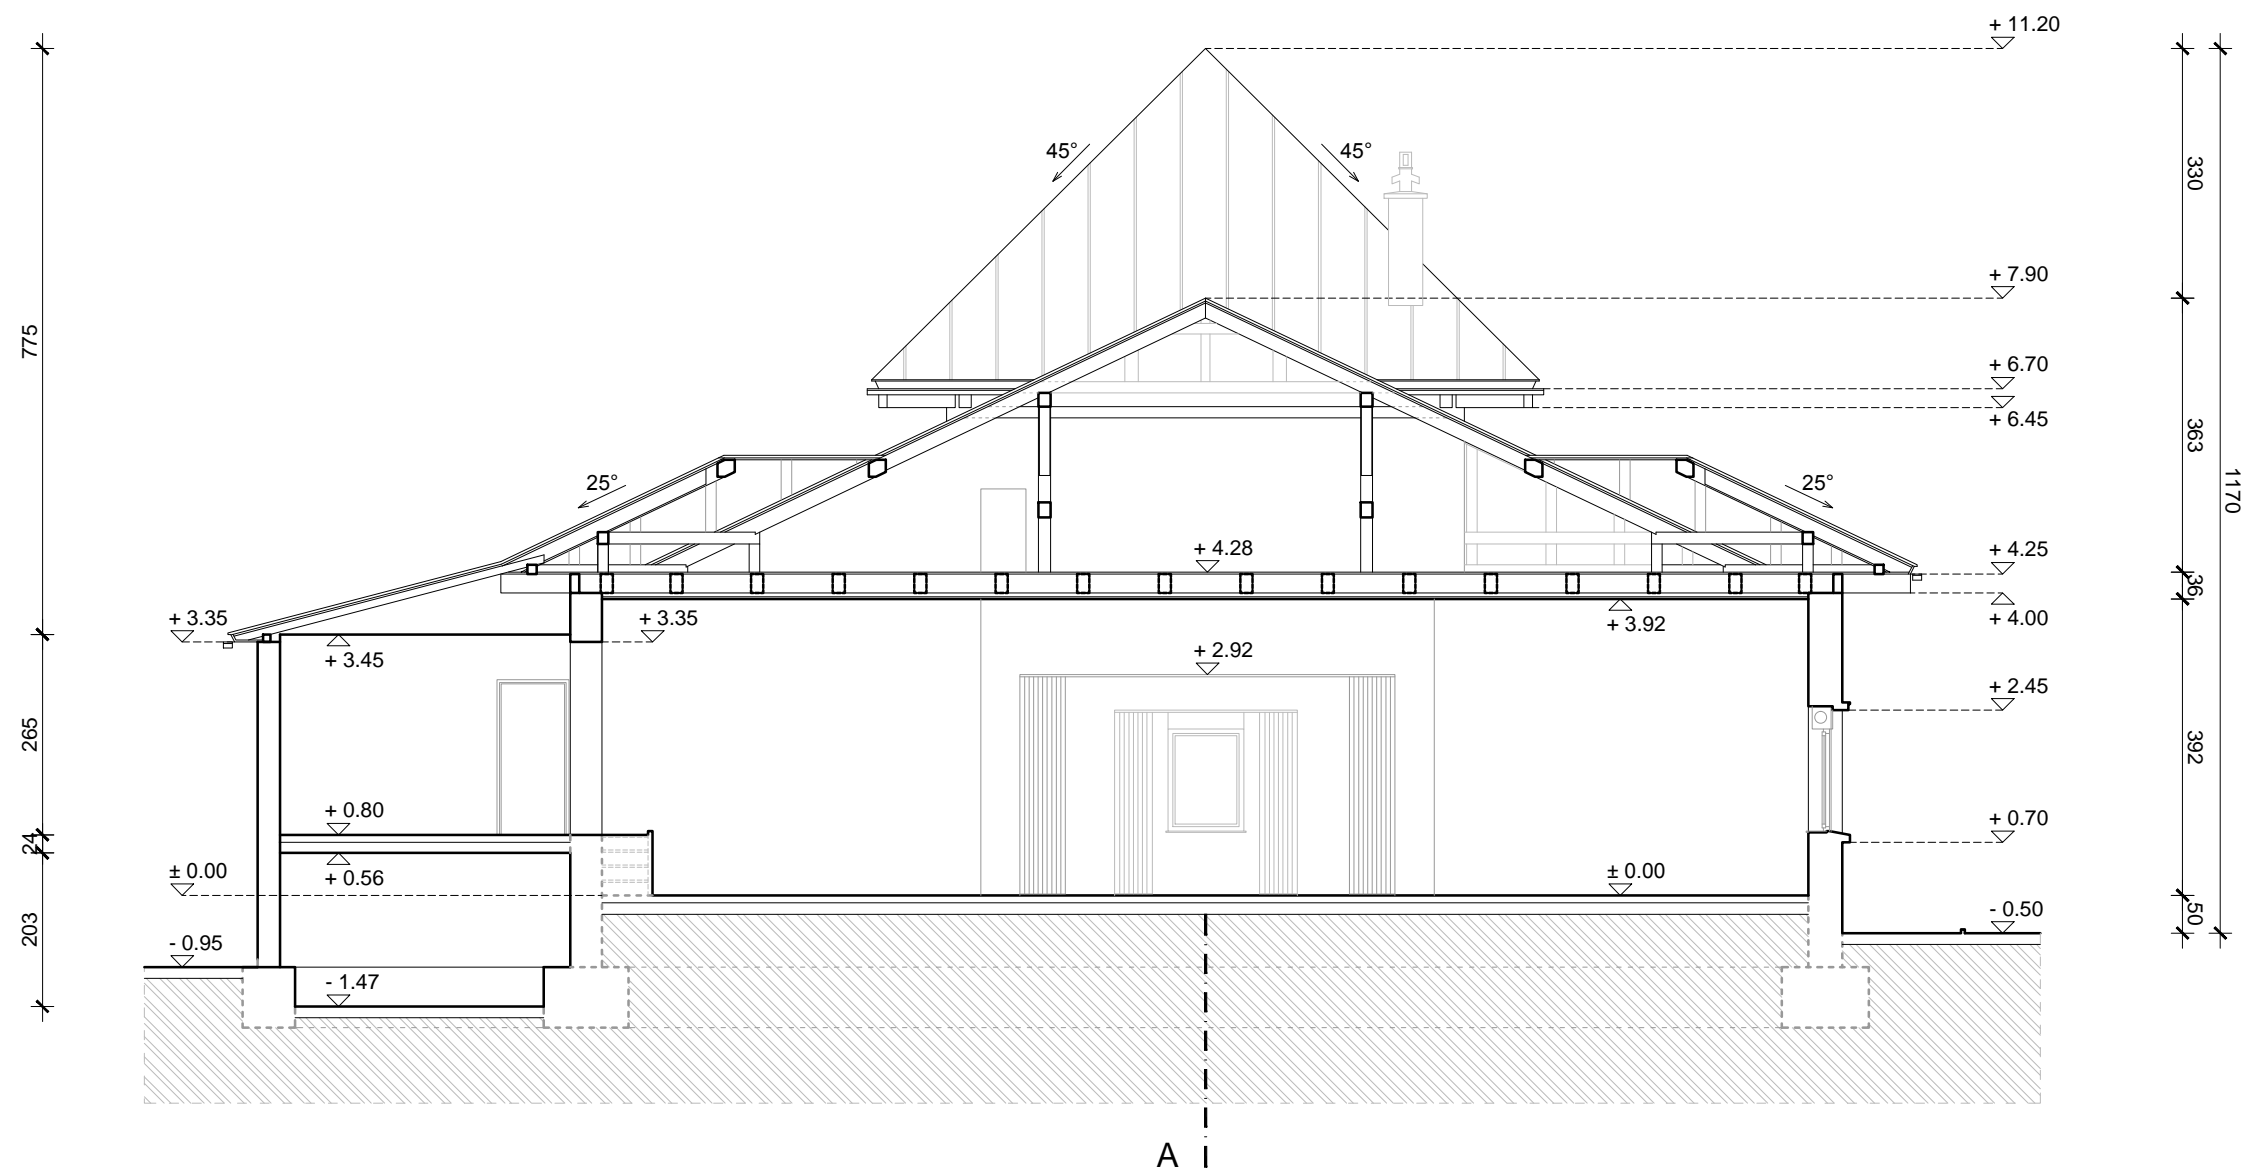

775  
265  
24  
203

330  
363  
36  
392  
50

30 384 42 1596 45  
2096

A I

		LIST: 7	